



As Built Ground Floor Plan

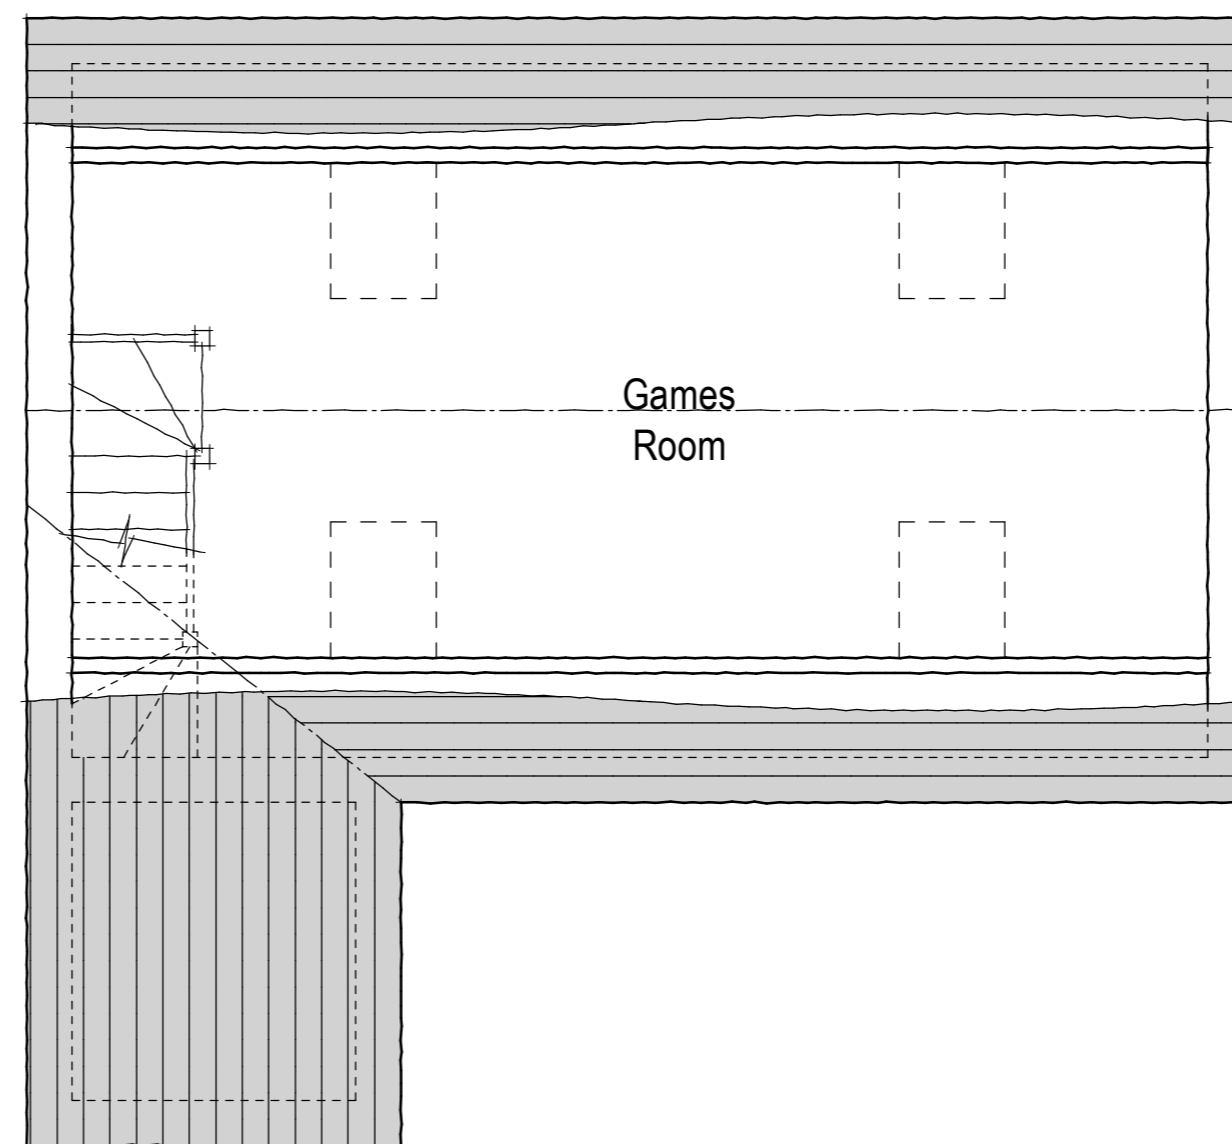

As Built Roof Space Plan

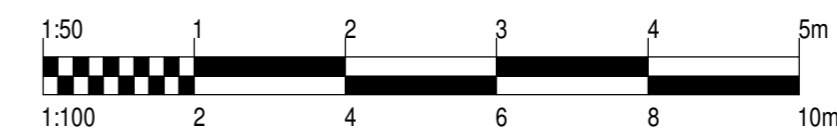

REV.	DATE	DESCRIPTION	BY
A	08/01/24	KITCHENETTE INDICATED	GCD

GD Designs
Architectural Services

49, The Crescent,
Cradley Heath,
West Midlands,
B64 7JS
Tel 0121 602 6233
Mob 07939 436557

contract
DETACHED ANCILLARY BUILDING
41, WARWICK ROAD,
OLDBURY. B68 ONE

drawing
AS BUILT PLANS & ELEVATIONS

client
MR ENVER BAJRAMI

scale
1:50/1:100@A2

date
JULY 2023

drawn by
GCD

drawing no
GD2538/03

rev
A

plot
09/25/11
D & T E
06/01/2024

cad lines